


Riverwalk

Stage 14

Wyndham City Council

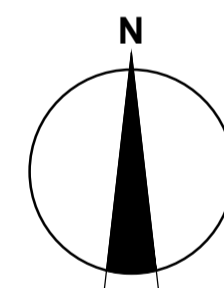

LOCALITY PLAN
MELWAYS REF: 244 F2

Places Victoria

Principal
Places Victoria
710 Collins Street
Docklands, VIC - 3008

Drawing Index

- 1932E-14-01 Cover Plan
- 1932E-14-02 Layout Plan
- 1932E-14-03 Signs & Linemarking Plan
- 1932E-14-04 Earthworks Plan
- 1932E-14-05 Intersection Detail Plan
- 1932E-14-06 Lip Profiles
- 1932E-14-07 Setout Information
- 1932E-14-08 Longitudinal Sections
- 1932E-14-09 Cross Sections: Buckland Circuit
- 1932E-14-10 Cross Sections: Gellibrand Street Ch 30.180 - Ch 120.571
- 1932E-14-11 Cross Sections: Gellibrand Street Ch 132.966 - Ch 176.279
- 1932E-14-12 Cross Sections: Riparian Street
- 1932E-14-13 Drainage Longitudinal Sections - 1
- 1932E-14-14 Drainage Longitudinal Sections - 2
- 1932E-14-15 Drainage Longitudinal Sections - 3
- 1932E-14-16 Drainage Longitudinal Sections - 4 & Pit Schedule
- 1932E-14-17 General Notes & Details
- 1932E-14-18 Open Channel Plan, Longitudinal Section & Typical Cross Section
- 1932E-14-85 Safety In Design Information



Level 10, 71 Queens Rd,
Melbourne, VIC, 3004
Tel: +61 3 9514 1500
Fax: +61 3 9514 1502

A.B.N. 47 065 475 149

AS CONSTRUCTED PLANS
The purpose of these as-constructed plans is to update the design drawings to show significant changes which occurred during construction. Note that the levels shown on these plans are design levels, and have not been verified by survey. All information shown on these plans should be verified on site.
SMEC accept no responsibility for loss or damages resulting from the inappropriate usage of these plans.


WARNING
SAFETY MEASURES REQUIRED
Please note there are risks attached to the construction of this project, and any ongoing maintenance of structures. Consider the safety of all. For potential risks, consequences and controls refer to Safety In Design Risk Register SID P4.E6. 1932E-14-85
ASSESS THE RISK - STAY SAFE



- NOTES:**
- EXISTING SERVICES TO BE REMOVED.
 - ALL EXISTING TREES NOT REQUIRED AS PART OF THESE WORKS WILL BE NEED TO BE REMOVED OR RELOCATED.
 - REFER TO SHEET 17 FOR PARKING BAY DETAILS
 - ALL CURVED PIPES TO BE ACHIEVED BY USING MELBOURNE WATER STANDARD STD 7251/8/308 CONCRETE MAKE UP JOINTS ON CURVED PIPELINES.
 - KERBS TO TIE INTO EXISTING LEVELS AND TRANSITION TO GAA STANDARDS AS SPECIFIED.
 - SURROUNDING BATTERS, TEMPORARY DRAINAGE & SWALES ONLY TO BE CONSTRUCTED IF FUTURE STAGES HAVE NOT COMMENCED.
 - ALL PROPERTY CONNECTIONS FOR FUTURE LOTS TO BE BOARDED UP AND MARKER POSTS.
 - TEMPORARY CUTOFF DRAINS NEED TO BE FILLED IN AS PART OF WORKS. THEY ARE TO BE EXCAVATED TO A FIRM BASE AND BACKFILLED TO LEVEL 1 SPECIFICATION TO SATISFACTION OF THE SUPERINTENDENT.


LEGEND - LAYOUT PLAN

- STORMWATER DRAIN, PIT & PROPERTY INLET
- SWALE DRAIN
- SEWER & MAINTENANCE STRUCTURES
- HOUSE DRAIN
- ELECTRICITY (U.GROUND) (INDICATIVE ONLY)
- ELECTRICITY (O.HEAD) (INDICATIVE ONLY)
- GAS (INDICATIVE ONLY)
- TELSTRA (INDICATIVE ONLY)
- WATER (INDICATIVE ONLY)
- RECYCLED WATER (INDICATIVE ONLY)
- AG. DRAIN (INDICATIVE ONLY)
- OPTIC FIBRE (INDICATIVE ONLY)
- SERVICE CONDUITS
- TACTILE PAVERS
- EXISTING ELECTRICITY (UNDERGROUND) (INDICATIVE ONLY)
- EXISTING ELECTRICITY (OVERHEAD) (INDICATIVE ONLY)
- EXISTING GAS (INDICATIVE ONLY)
- EXISTING TELSTRA (INDICATIVE ONLY)
- EXISTING OPTIC FIBRE (INDICATIVE ONLY)
- EXISTING WATER (INDICATIVE ONLY)
- EXISTING RECYCLED WATER (INDICATIVE ONLY)
- EXISTING STORMWATER DRAIN (INDICATIVE ONLY)
- EXISTING SEWER (INDICATIVE ONLY)
- EXISTING HOUSE DRAIN
- EXISTING SWALE DRAIN
- FUTURE AG DRAIN (INDICATIVE ONLY)
- FUTURE ELECTRICITY (UNDERGROUND) (INDICATIVE ONLY)
- FUTURE ELECTRICITY (OVERHEAD) (INDICATIVE ONLY)
- FUTURE GAS (INDICATIVE ONLY)
- FUTURE TELSTRA (INDICATIVE ONLY)
- FUTURE OPTIC FIBRE (INDICATIVE ONLY)
- FUTURE WATER (INDICATIVE ONLY)
- FUTURE RECYCLED WATER (INDICATIVE ONLY)
- FUTURE STORMWATER DRAIN (INDICATIVE ONLY)
- FUTURE SEWER (INDICATIVE ONLY)
- FUTURE HOUSE DRAIN
- EXISTING SURFACE LEVEL
- FINISHED BUILDING LINE LEVEL
- FINISHED RIDGE LINE LEVEL
- TOP OF RETAINING WALL
- BOTTOM OF RETAINING WALL
- RETAINING WALL
- ZERO LOT LINES
- PAVEMENT TREATMENT
- STRUCTURAL FILL > 200mm DEEP
- EX. STRUCTURAL FILL > 200mm DEEP
- DIRECTION OF FALL
- OVERLAND FLOW
- ALLOTMENT TO BE GRADED EVENLY IN DIRECTION OF FALL TO LEVELS INDICATED
- CONCRETE EDGE STRIP WITH SUBSOIL DRAIN, "NO ROAD" SIGN & BARRIER
- LIMIT OF WORKS
- EXISTING TREE TO BE REMOVED
- EXISTING TREE TO BE RETAINED
- PERMANENT SURVEY MARK
- TEMPORARY BENCH MARK
- PROPOSED DRIVEWAY

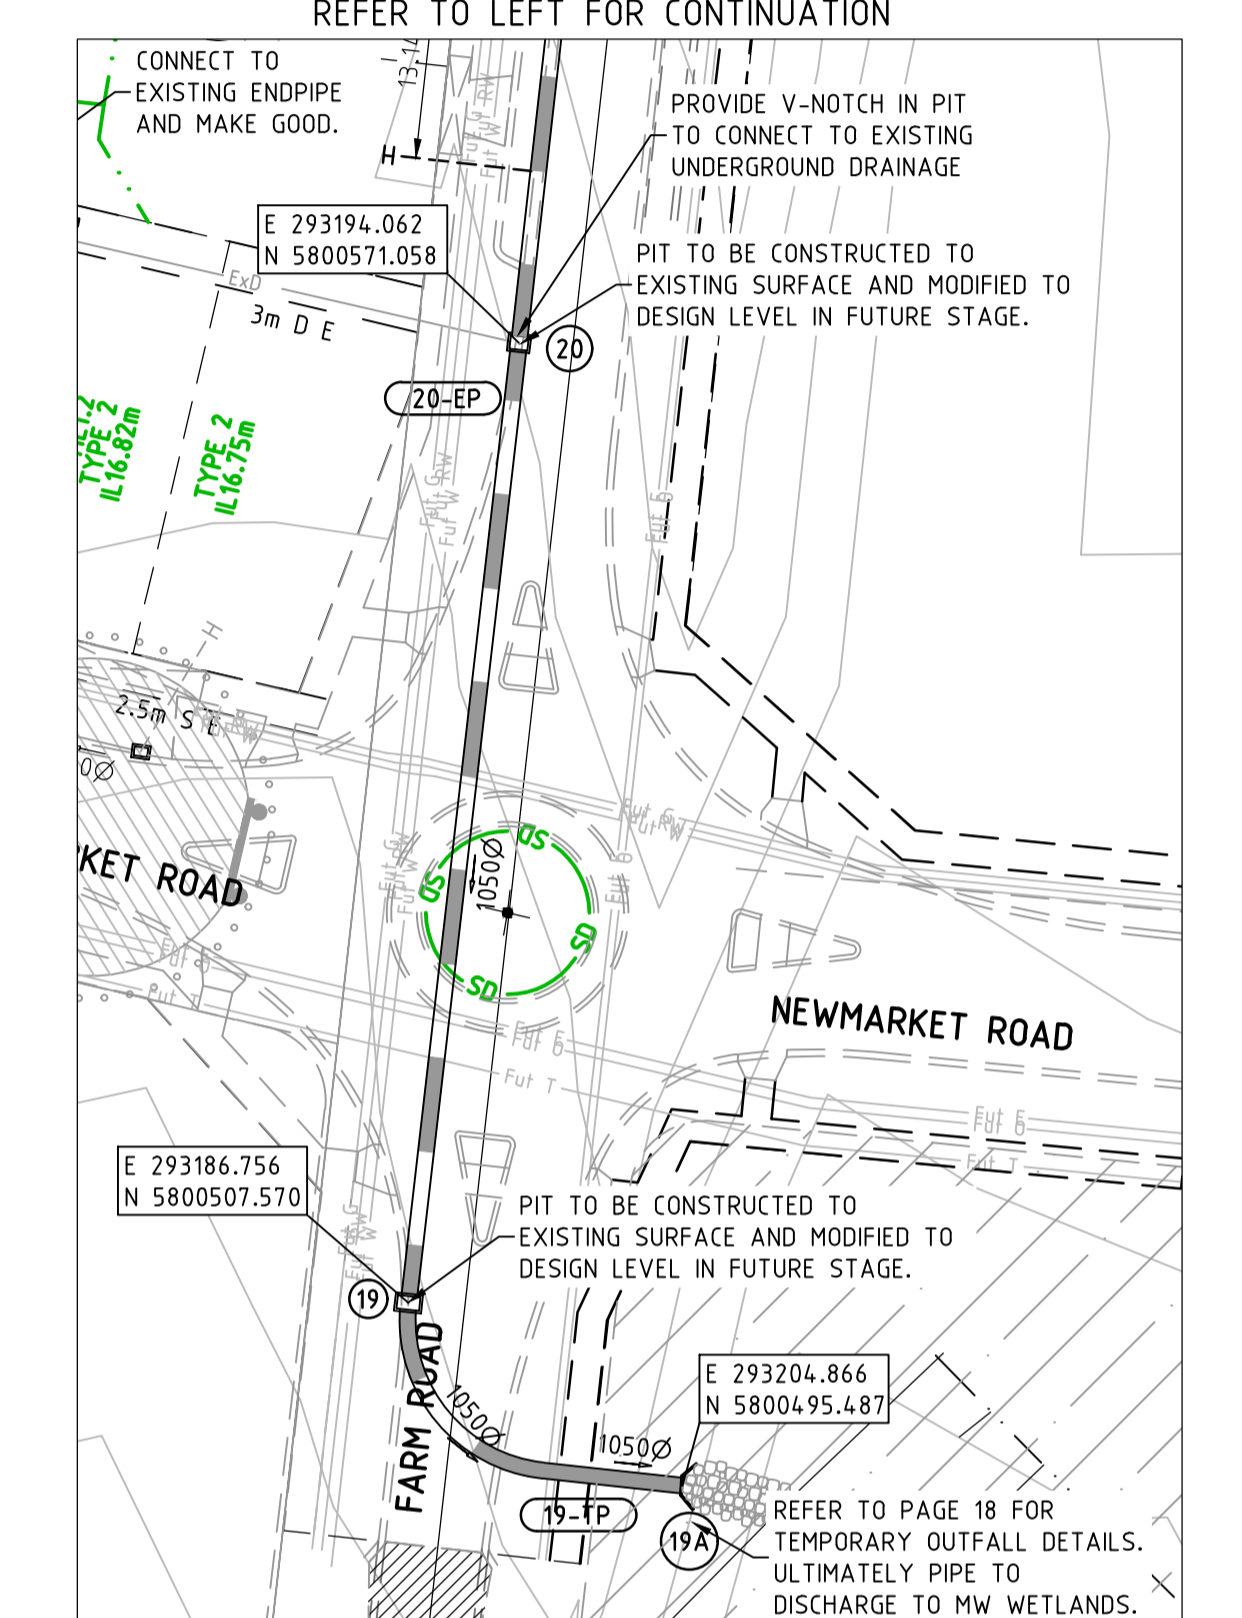

WARNING
BEWARE OF UNDERGROUND SERVICES
 The locations of underground services are approximate only and their exact position should be proven on site. No guarantee is given that all existing services are shown. Locate all underground services before commencement of works.
DIAL 1100 BEFORE YOU DIG
 www.1100.com.au

AS CONSTRUCTED PLANS
 The purpose of these as-constructed plans is to update the design drawings to show significant changes which occurred during construction. Note that the levels shown on these plans are design levels, and have not been verified by survey. All information shown on these plans should be verified on site. SMEC accept no responsibility for loss or damages resulting from the inappropriate usage of these plans.

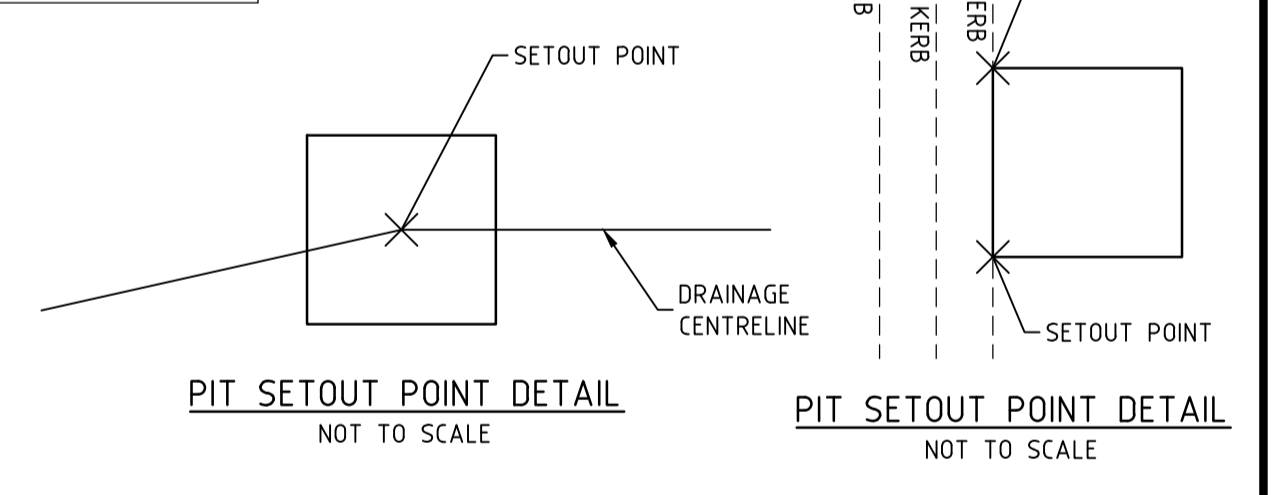

SERVICES OFFSET SCHEDULE

| ROAD NAME | GAS | | WATER | | RECYCLED WATER | | ELECTRICITY | | OPTIC FIBRE | |
|------------------------|-------|------------|-------|------------|----------------|------------|-------------|------------|-------------|------------|
| | SIDE | OFFSET (m) | SIDE | OFFSET (m) | SIDE | OFFSET (m) | SIDE | OFFSET (m) | SIDE | OFFSET (m) |
| GELLIBRAND STREET | NORTH | 2.05 | NORTH | 3.05 | NORTH | 2.55 | SOUTH | 2.60 | SOUTH | 1.85 |
| RIPARIAN STREET | EAST | 2.25 | EAST | 3.25 | EAST | 2.75 | WEST | 2.60 | WEST | 1.85 |
| BUCKLAND CIRCUIT (W-E) | NORTH | 2.25 | NORTH | 3.25 | NORTH | 2.75 | SOUTH | 2.60 | SOUTH | 1.85 |
| BUCKLAND CIRCUIT (S-N) | EAST | 2.25 | EAST | 3.25 | EAST | 2.75 | WEST | 2.60 | WEST | 1.85 |

ROAD LAYOUT TABLE


| ROAD NAME | ROAD CLASSIFICATION | RESERVE WIDTH (m) | ROAD WIDTH (m) | | | | KERB TYPE | | VERGE WIDTH (m) | |
|-------------------|---------------------|-------------------|----------------|------------|--------------|----------|-----------|----------|-----------------|--|
| | | | LIP to LIP | INV to INV | BACK to BACK | NTH/WEST | STH/EAST | NTH/WEST | STH/EAST | |
| GELLIBRAND STREET | A51 | 16.00 | 6.10 | 7.00 | 7.30 | WB2 | WB2 | 4.35 | 4.35 | |
| RIPARIAN STREET | A51 | 16.00 | 6.10 | 7.00 | 7.30 | WB2 | WB2 | 4.35 | 4.35 | |
| BUCKLAND CIRCUIT | A51 | 16.00 | 6.10 | 7.00 | 7.30 | WB2 | WB2 | 4.35 | 4.35 | |

| REVISION | DATE | DES/DFT | APPD |
|----------|----------|---------|------|
| 2 | 04.05.17 | AM/AM | MB |
| 1 | 05.07.16 | BC | MB |
| 0 | 23.06.16 | BC/NS | MB |

Places Victoria
 Principal
 Places Victoria
 710 Collins Street
 Docklands, VIC - 3008

All setting out should be carried out in accordance with GAA/Council's standard drawings or as nominated on hard copy plans provided by SMEC. Any digital information supplied by this office is for information only. Any discrepancies should be discussed with the superintendent.

Designed
 B.Cheung
 Drawn
 S.Sathisviam
 Checked
 L.Vieyra
 Authorised
 S.Sjalatas
 Date
 November 2015

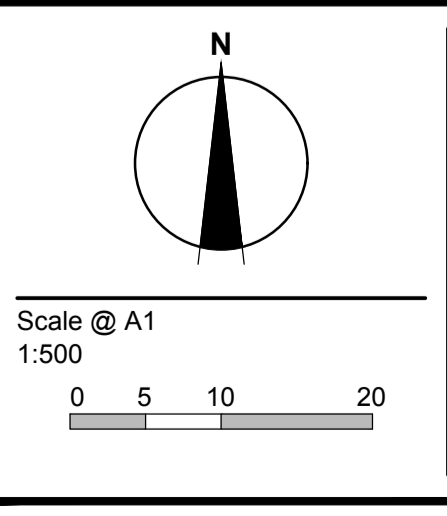

© SMEC Australia Pty Ltd
 ABN 47 065 475 148
 These designs and drawings are the copyright of SMEC Australia Pty Ltd.
 The drawing shall not be reproduced or copied, in whole or part, without the written permission of SMEC Australia Pty Ltd.
 The contents of this drawing are electronically generated, are confidential and may only be used for the purpose for which they are intended.

URBAN DEVELOPMENT
 Level 10, 71 Queens Road, Melbourne VIC 3004
 p +61 3 9514 1500 | f +61 3 9514 1502 | www.smec.com

Riverwalk
 Stage 14
 Wyndham City Council
 Roadworks and Drainage
 Layout Plan

Drawing No. 1932E-14-02 **Rev 2**
 Sheet No. 2 of 19

As Constructed

I:\work\1932e - riverwalk\1932e - 14.dwg\1932e-14.dwg